PROJECT DESCRIPTION

GENERAL

THIS PROJECT INVOLVES THE INSTALLATION OF A NEW TRAFFIC CONTROLLER AND SIGNALS INCLUDING THE INSTALLATION OF VIDEO DETECTION AT THE INTERSECTION OF MD 450 AT BOWIE HIGHSCHOOL ENTRANCE IN PRINCE GEORGE'S COUNTY. MD 450 IS ASSUMED TO RUN IN AN EAST/WEST DIRECTION.

INTERSECTION OPERATION

NORMAL OPERATION

[1] THE INTERSECTION WILL OPERATE IN A NEMA-~~FOUR~~THREE-PHASE, FULLY ACTUATED MODE. THE MOVEMENTS ON MD 450 WILL OPERATE CONCURRENTLY. THE MOVEMENTS AT THE SCHOOL'S ENTRANCE WILL OPERATE CONCURRENTLY. THE INTERSECTION CONTROLLER WILL INTERCONNECT WITH THE NEW CONTROLLER AT THE INTERSECTION OF MD 450 AT TRINITY/MOYLAN DRIVE AND AT THE INTERSECTION OF MD 450 AT BELAIR DRIVE.

CONTROLLER REQUIREMENTS

INSTALL A FULL-TRAFFIC-ACTUATED, SOLID STATE EIGHT PHASE CONTROLLER WITH SYSTEM PACKAGE, VIDEO RACK, TELEMETRY MODULE, ISOLATION BOARD AND SPECIAL RELAY HOUSED IN NEMA SIZE "6" BASE MOUNTED CABINET.

SPECIAL NOTE

ALL UTILITIES SHOWN ON THESE PLANS ARE SCHEMATIC AND ARE NOT TO BE CONSIDERED COMPLETE BECAUSE THESE UTILITIES MAY BE MODIFIED PRIOR TO AND DURING CONSTRUCTION. THE CONTRACTOR SHALL BE RESPONSIBLE FOR NOTIFYING ALL UTILITY COMPANIES PRIOR TO CONSTRUCTION SO THAT ALL UTILITIES MAY BE LOCATED IN THE FIELD. IF THE CONTRACTOR PERCEIVES THAT A CONFLICT BETWEEN THE UTILITIES AND THE TRAFFIC SIGNAL EQUIPMENT WILL OCCUR, THE CONTRACTOR SHALL NOTIFY THE PROJECT MANAGER IMMEDIATELY.

WIRING DIAGRAM

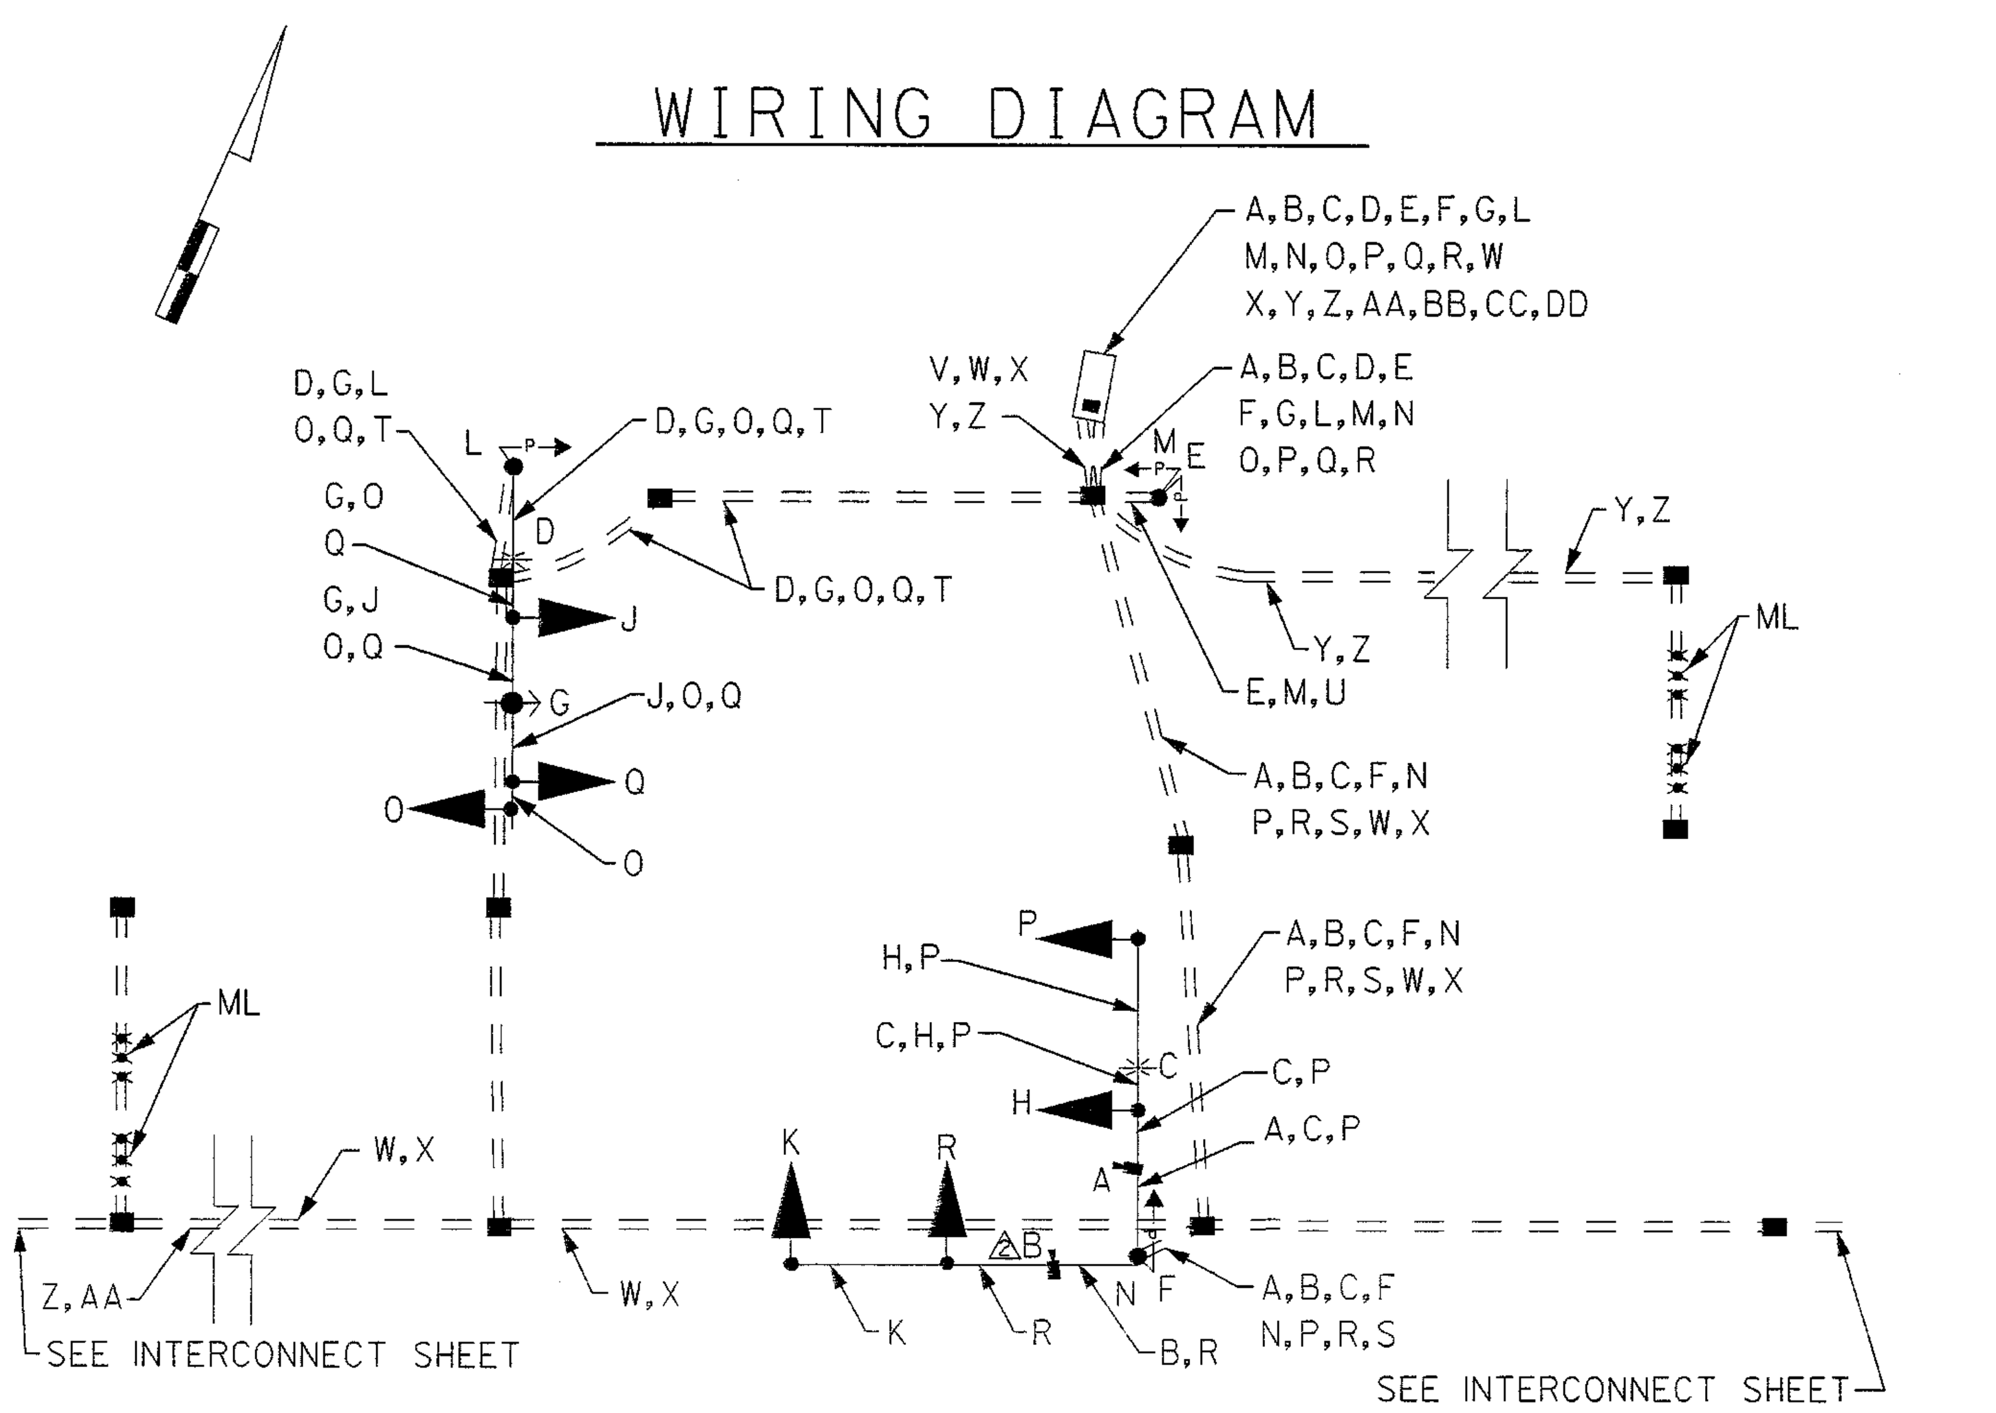

A,B	VIDEO TRAFFIC DETECTOR CABLE	O,P Q,R	ELECTRICAL CABLE 7-CONDUCTOR (NO. 14 AWG)
C,D	ELECTRICAL CABLE 2-CONDUCTOR (NO. 12 AWG)	S,T U,V	NO. 6 AWG STRANDED BARE COPPER GROUND WIRE
E,F	ELECTRICAL CABLE 2-CONDUCTOR (NO. 14 AWG)	W,X Y,Z	MICRO-LOOP 1000 FT. LEAD IN
G	ELECTRICAL CABLE 4-CONDUCTOR (NO. 20 AWG)	AA,BB CC	ELECTRICAL CABLE 1-CONDUCTOR (NO. 4 AWG)
H,J,K L,M,N	ELECTRICAL CABLE 5-CONDUCTOR (NO. 14 AWG)	ML	MICRO-LOOP NON INVASIVE PROBE SET

EQUIPMENT LIST "A"

A. EQUIPMENT TO BE SUPPLIED BY THE SHA

CAT CODE NUMBER	SPEC. SECTION	QUANTITY	DESCRIPTION
965001	806	2 EA.	PUSHBUTTON AND SIGN
971017	816	1 EA.	EIGHT PHASE, FULL TRAFFIC ACTUATED SOLID STATE DIGITAL CONTROLLER WITH SYSTEM PACKAGE, HOUSED IN A NEMA SIZE "6" BASE MOUNTED CABINET
973023	813	△2 71 S.F.	SHEET ALUMINUM SIGN TO CONSIST OF: -2 EA. R10-12 (36 IN. X 42 IN.)-MAST ARM MOUNT -1 EA. R3-5R (30 IN. X 36 IN.)-MAST ARM MOUNT -1 EA. R3-2 (36 IN. X 36 IN.)-MAST ARM MOUNT -2 EA. R10-41 (9 IN. X 12 IN.)-POLE MOUNT -1 EA. ASSOCIATED SHIELD ASSEMBLY (30 IN. X 51 IN.)-POLE MOUNT -1 EA. ASSOCIATED SHIELD ASSEMBLY (48 IN. X 75 IN.)-POLE MOUNT
900000	807	1 EA.	OPTICOM DISCRIMINATOR MODULE

PROJECT CONTACTS

THE CONTACT PERSONS FOR DISTRICT #3 ARE AS FOLLOWS:

[1] ~~CHARLIE WATKINS~~
~~DISTRICT ENGINEER~~
~~PHONE: 301-513-7300~~

ROBERT SNYDER ASSSISTANT DIVISION CHIEF
TRAFFIC OPERATION DIVISION
PHONE: 410-787-7630

RALEIGH MEDLEY
ASSISTANT DISTRICT ENGINEER-MAINTENANCE
PHONE: 301-513-7304

MAJID SHAKIB
ASSISTANT DISTRICT ENGINEER-TRAFFIC
PHONE: 301-513-7358

AUGIE REBISH
△2 ASSISTANT DISTRICT ENGINEER-UTILITIES
PHONE: 301-513-7350

PHASE CHART

	1	2	3	4	5	6	7	9	10	11	12	
△2 PHASE 1+6 (LAG LEFT)	G ◄G–	G ◄G–	G	R	R	R	R	DW	DW	DW	DW	
1+6 CHANGE	G ◄Y–	G ◄Y–	G	R	R	R	R	DW	DW	DW	DW	
PHASE 2+6	G	G	G	G	G	R	R	DW	DW	WK	WK	
	G	G	G	G	G	R	R	DW	DW	FL/DW	FL/DW	
2+6 CHANGE	Y	Y	Y	Y	Y	R	R	DW	DW	DW	DW	
PHASE 4	R	R	R	R	R	R	R	WK	WK	DW	DW	
	R	R	R	R	R	G	G	FL/DW	FL/DW	DW	DW	
4 CHANGE	R	R	R	R	R	Y	Y	DW	DW	DW	DW	
FLASHING OPERATION	FL/Y	FL/Y	FL/Y	FL/Y	FL/Y	FL/R	FL/R	DARK	DARK	DARK	DARK	

EQUIPMENT LIST "B"

B. EQUIPMENT TO BE FURNISHED AND INSTALLED BY THE CONTRACTOR

CAT CODE NUMBER	SPEC. SECTION	QUANTITY	DESCRIPTION
203030	205	3 C.Y.	TEST PIT EXCAVATION
585620	556	△2 500 L.F.	12 IN. HEAT APPLIED THERMOPLASTIC WHITE PAVEMENT MARKING
585624	556	△2 100 L.F.	24 IN. HEAT APPLIED THERMOPLASTIC WHITE PAVEMENT MARKING
801004	801	△2 12 C.Y.	CONCRETE FOR SIGNAL FOUNDATION
802501	805	235 L.F.	NO. 6 AWG STRANDED BARE COPPER GROUND WIRE
810010	810	45 L.F.	ELECTRICAL CABLE 1-CONDUCTOR (NO. 4 AWG)
811001	811	12 EA.	ELECTRICAL HANDHOLE
[1] △2 81301~~1~~14	813	25 S.F.	GROUND MOUNTED SIGN
813015	813	△2 69 S.F.	INSTALL OVERHEAD SIGN
818010	818	1 EA.	14 FT. BREAKAWAY PEDESTAL POLE
831010	806	△2 2 EA.	250 WATT HPS LUMINAIRE WITH PHOTOCELL
837001	804	4 EA.	GROUND ROD 3/4 IN. X 10 FT. LENGTH
838003	807	1 EA.	CONTROL AND DISTRIBUTION EQUIPMENT (120/240V, 1 PHASE, 3 WIRE SYSTEM)
860270	814	3 EA.	8 IN. VEHICULAR TRAFFIC SIGNAL HEAD SECTION
860272	814	22 EA.	12 IN. VEHICULAR TRAFFIC SIGNAL HEAD SECTION
860278	814	4 EA.	12 IN. PEDESTRIAN SIGNAL HEAD SECTION (POLE MOUNT)
860282	814	4 EA.	12 IN. PEDESTRIAN SIGNAL HEAD SECTION (PEDESTAL MOUNT)
861107	810	440 L.F.	ELECTRICAL CABLE 5-CONDUCTOR (NO. 14 AWG)
861108	810	810 L.F.	ELECTRICAL CABLE 7-CONDUCTOR (NO. 14 AWG)
861116	810	370 L.F.	ELECTRICAL CABLE 2-CONDUCTOR (NO. 12 AWG)
865001	806	2 EA.	INSTALL PUSHBUTTON
866104	818	2 EA.	20 FT. LIGHTING ARM ON SIGNAL STRUCTURE
866204	818	1 EA.	27 FT. STEEL POLE WITH 60 FT. MAST ARM
866205	818	1 EA.	27 FT. STEEL POLE WITH TWIN 38/50 FT. MAST ARMS
870163	805	49 L.F.	3 IN. SCHEDULE 80 RIGID PVC ELECTRICAL CONDUIT-TRENCHED
870164	805	91 L.F.	3 IN. SCHEDULE 80 RIGID PVC ELECTRICAL CONDUIT-BORED
870166	805	627 L.F.	4 IN. SCHEDULE 80 RIGID PVC ELECTRICAL CONDUIT-TRENCHED
870167	805	73 L.F.	4 IN. SCHEDULE 80 RIGID PVC ELECTRICAL CONDUIT-BORED
870168	805	78 L.F.	4 IN. SCHEDULE 80 RIGID PVC ELECTRICAL CONDUIT-SLOTTED
871117	816	1 EA.	INSTALL CONTROLLER AND CABINET-BASE MOUNT
800000	805	1 EA.	VIDEO TRAFFIC DETECTION SYSTEM
800000	805	2 EA.	△2 VIDEO TRAFFIC DETECTOR 500 FT. CABLE
800000	807	1 EA.	OPTICOM DETECTOR EYE
800000	810	240 L.F.	ELECTRICAL CABLE 2-CONDUCTOR (NO. 14 AWG)
800000	810	175 L.F.	ELECTRICAL CABLE 4-CONDUCTOR (NO. 20 AWG)
800000	810	4 EA.	MICRO-LOOP NON INVASIVE PROBE SET WITH 1000 FT. LEAD IN

EQUIPMENT LIST "C"

△2 NONE

[1] REDLINE NO. 1 5/6/02

△2 ADDENDUM #2 10/11/2001

THE WILSON T. BALLARD CO.
CONSULTING ENGINEERS
OWINGS MILLS, MARYLAND

MARYLAND DOT - STATE HIGHWAY ADMINISTRATION
Office of Traffic & Safety
TRAFFIC ENGINEERING DESIGN DIVISION

GENERAL INFORMATION SHEET
MD 450 - MD 193 TO STONYBROOK DRIVE
MD 450 AT BOWIE HIGHSCHOOL ENTRANCE - ULTIMATE

DRAWN BY:	MB	F.A.P. NO.	SEE TITLE SHEET	TS NO.	SHEET NO.
CHECKED BY:	STB	S.H.A. NO.	PG9005571		
SCALE:	NONE	COUNTY:	PRINCE GEORGE'S	T.I.M.S. NO.	
DATE:	OCTOBER 2001	LOG MILE:		D 538	432 OF 545

f:\md450e\d5389g09.r4l
4/22/02 bcd
t:\plotsta\pentables\m450-col.tbl